


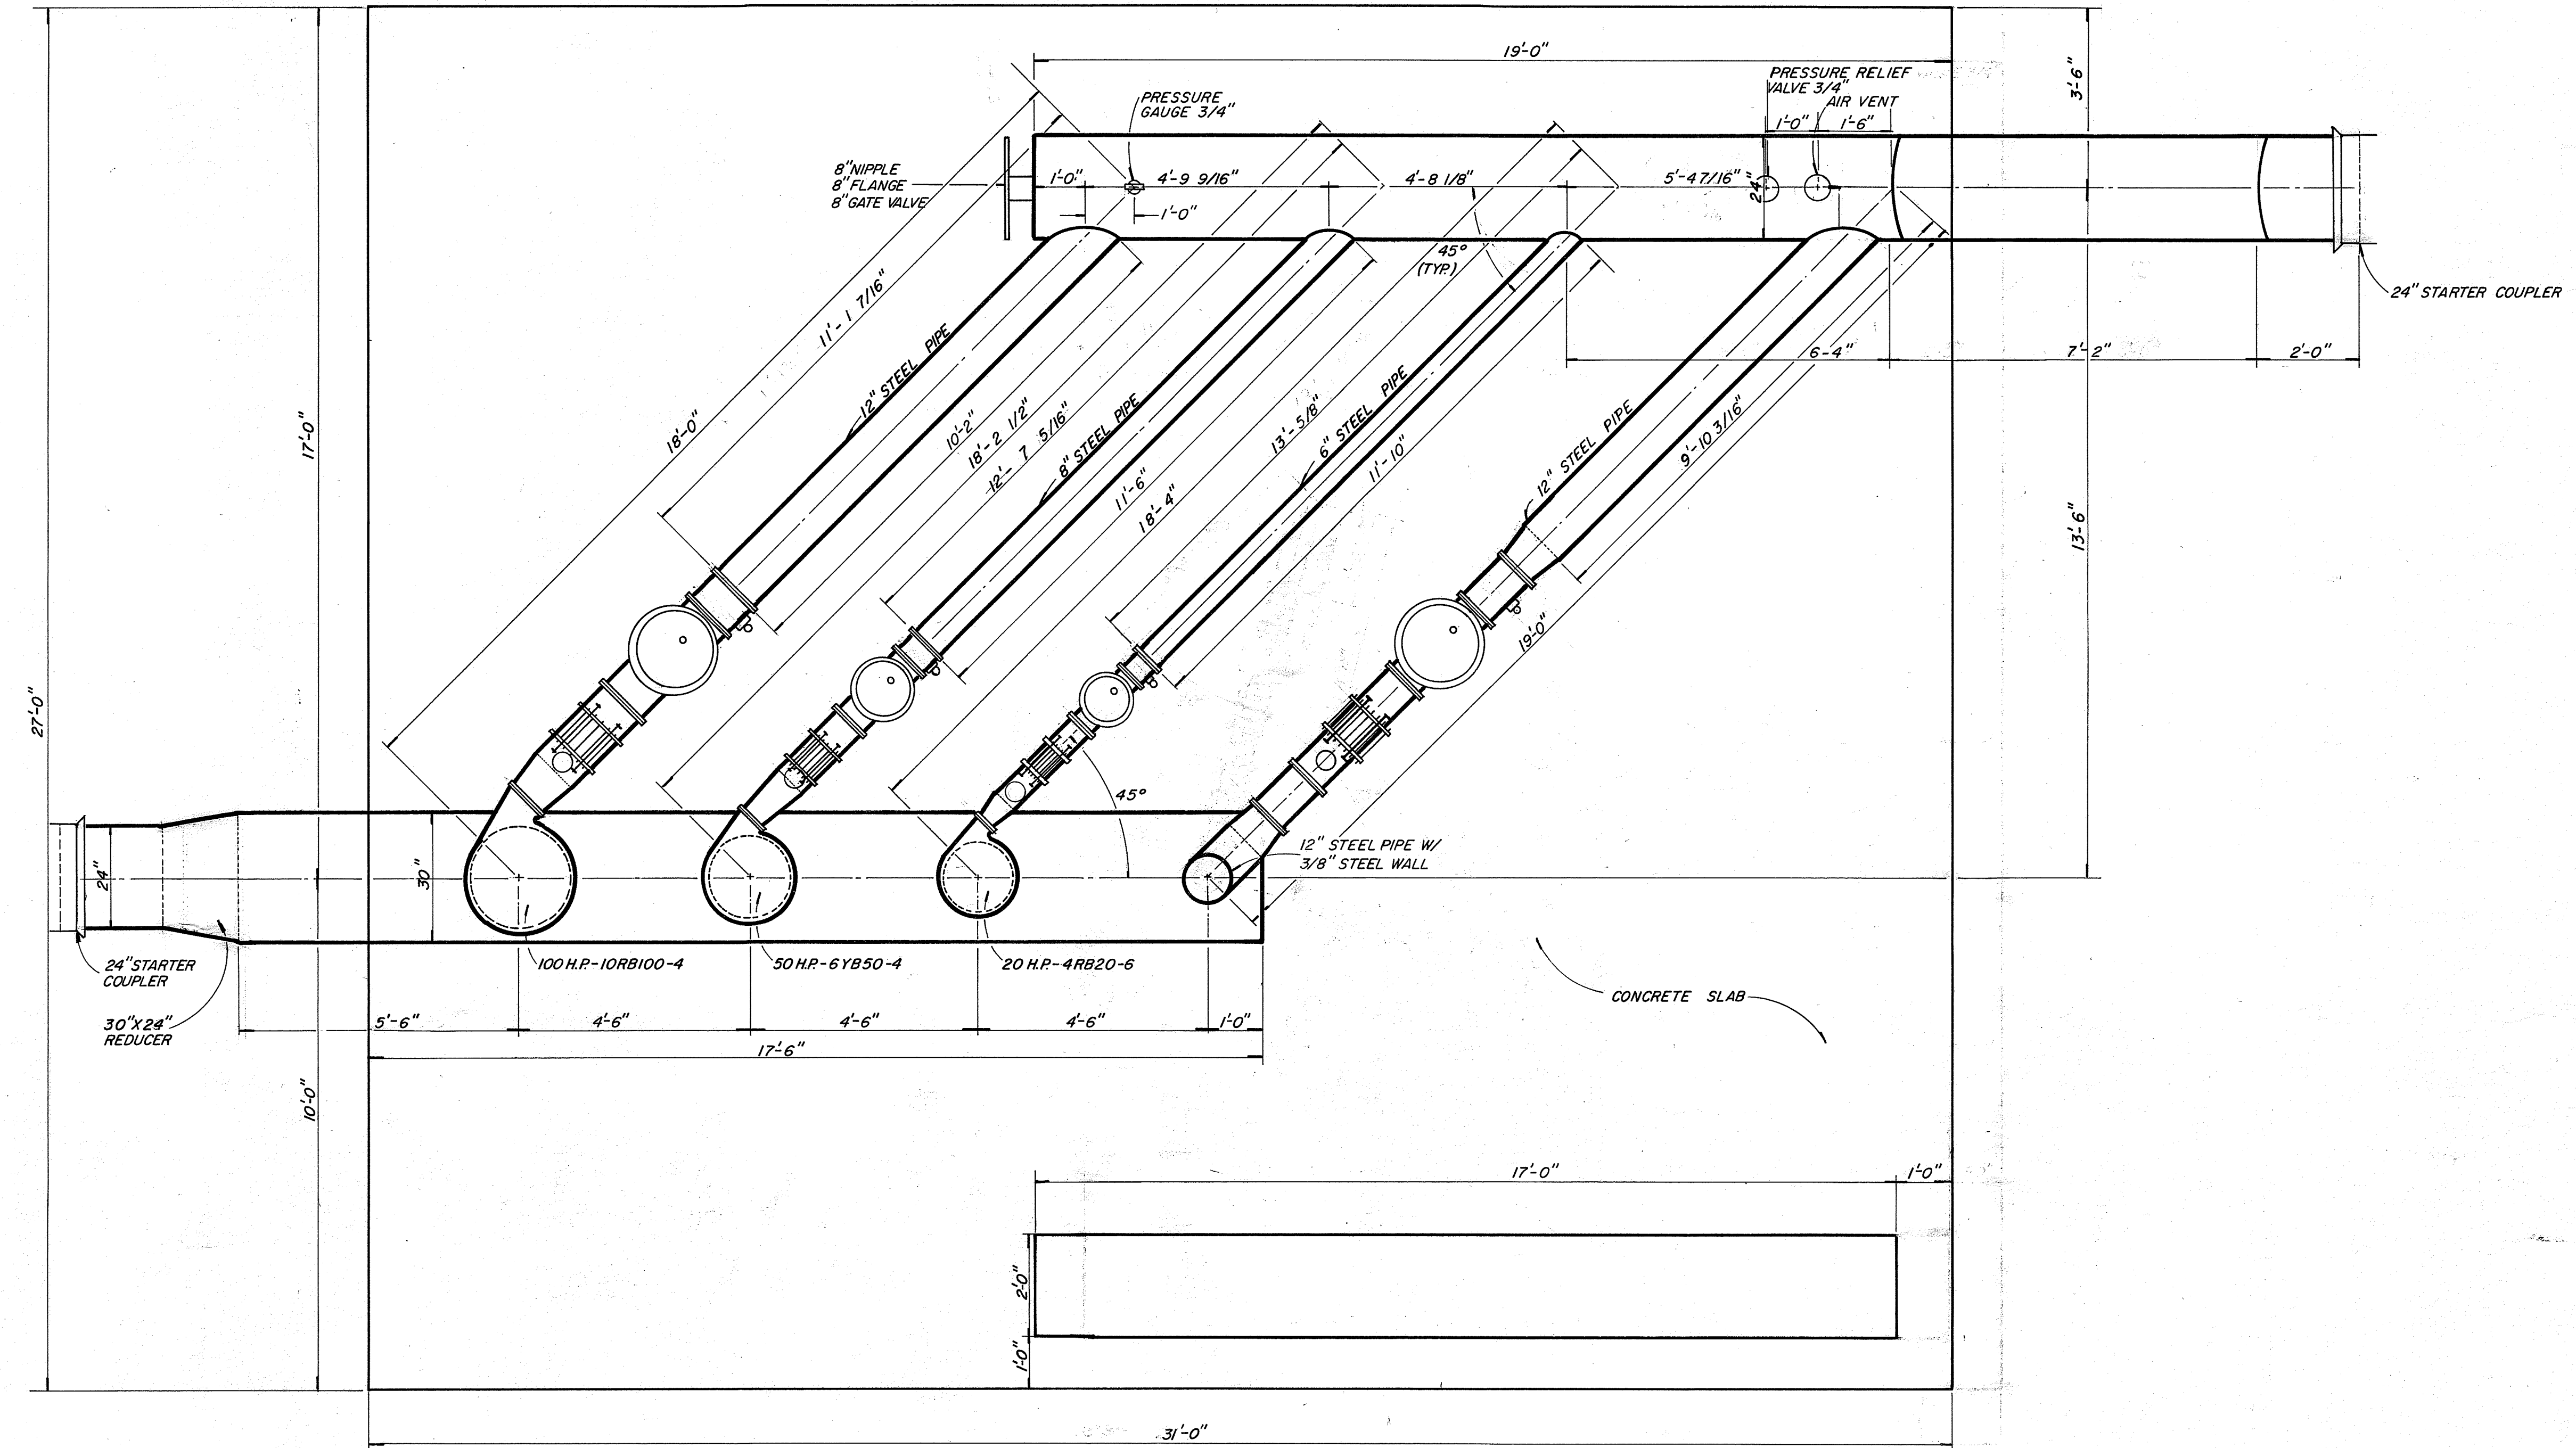


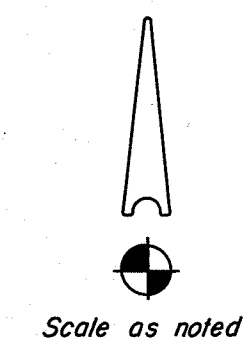

PLAN VIEW
Scale: 1/2" = 1'-0"

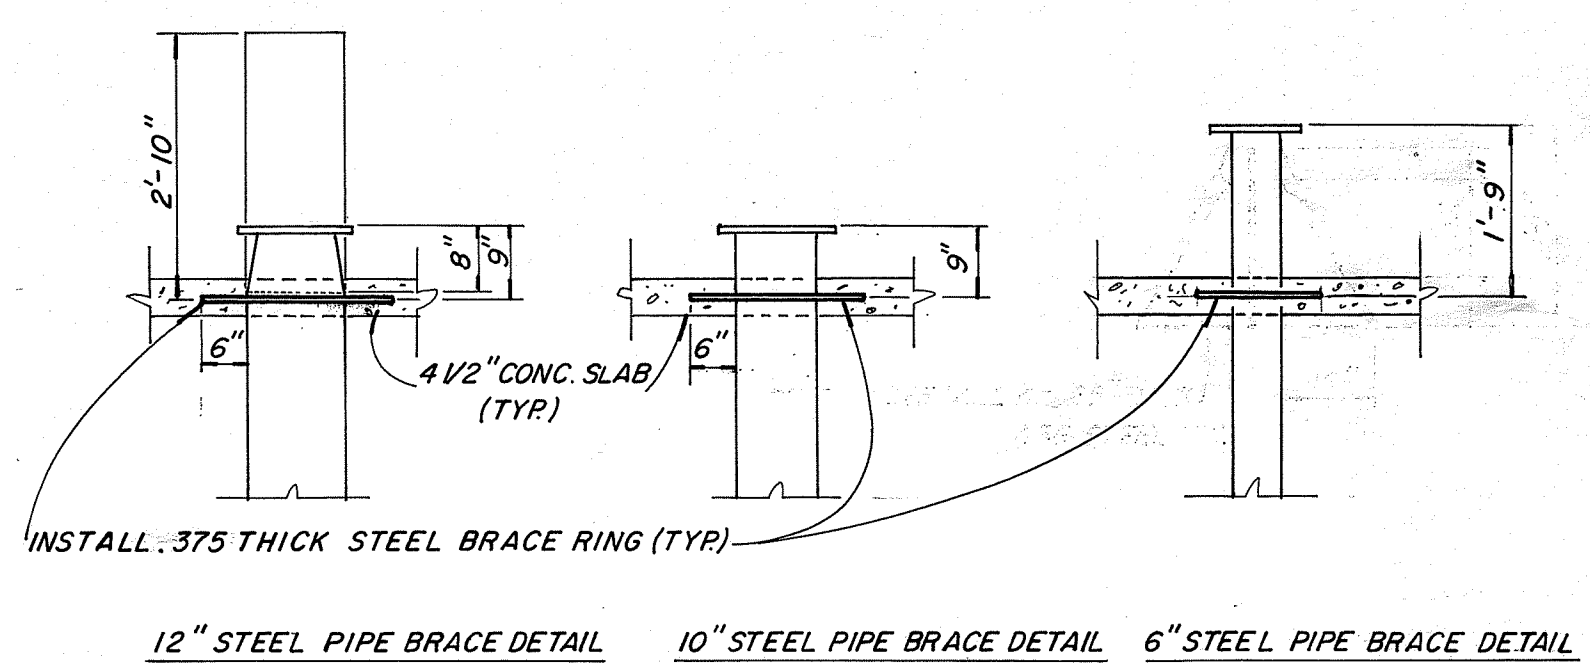

NOTE:
ALL STEEL PIPE WILL HAVE A 3/16" WALLS
UNLESS OTHERWISE NOTED
* AS-BUILT, REVISED 7-5-95

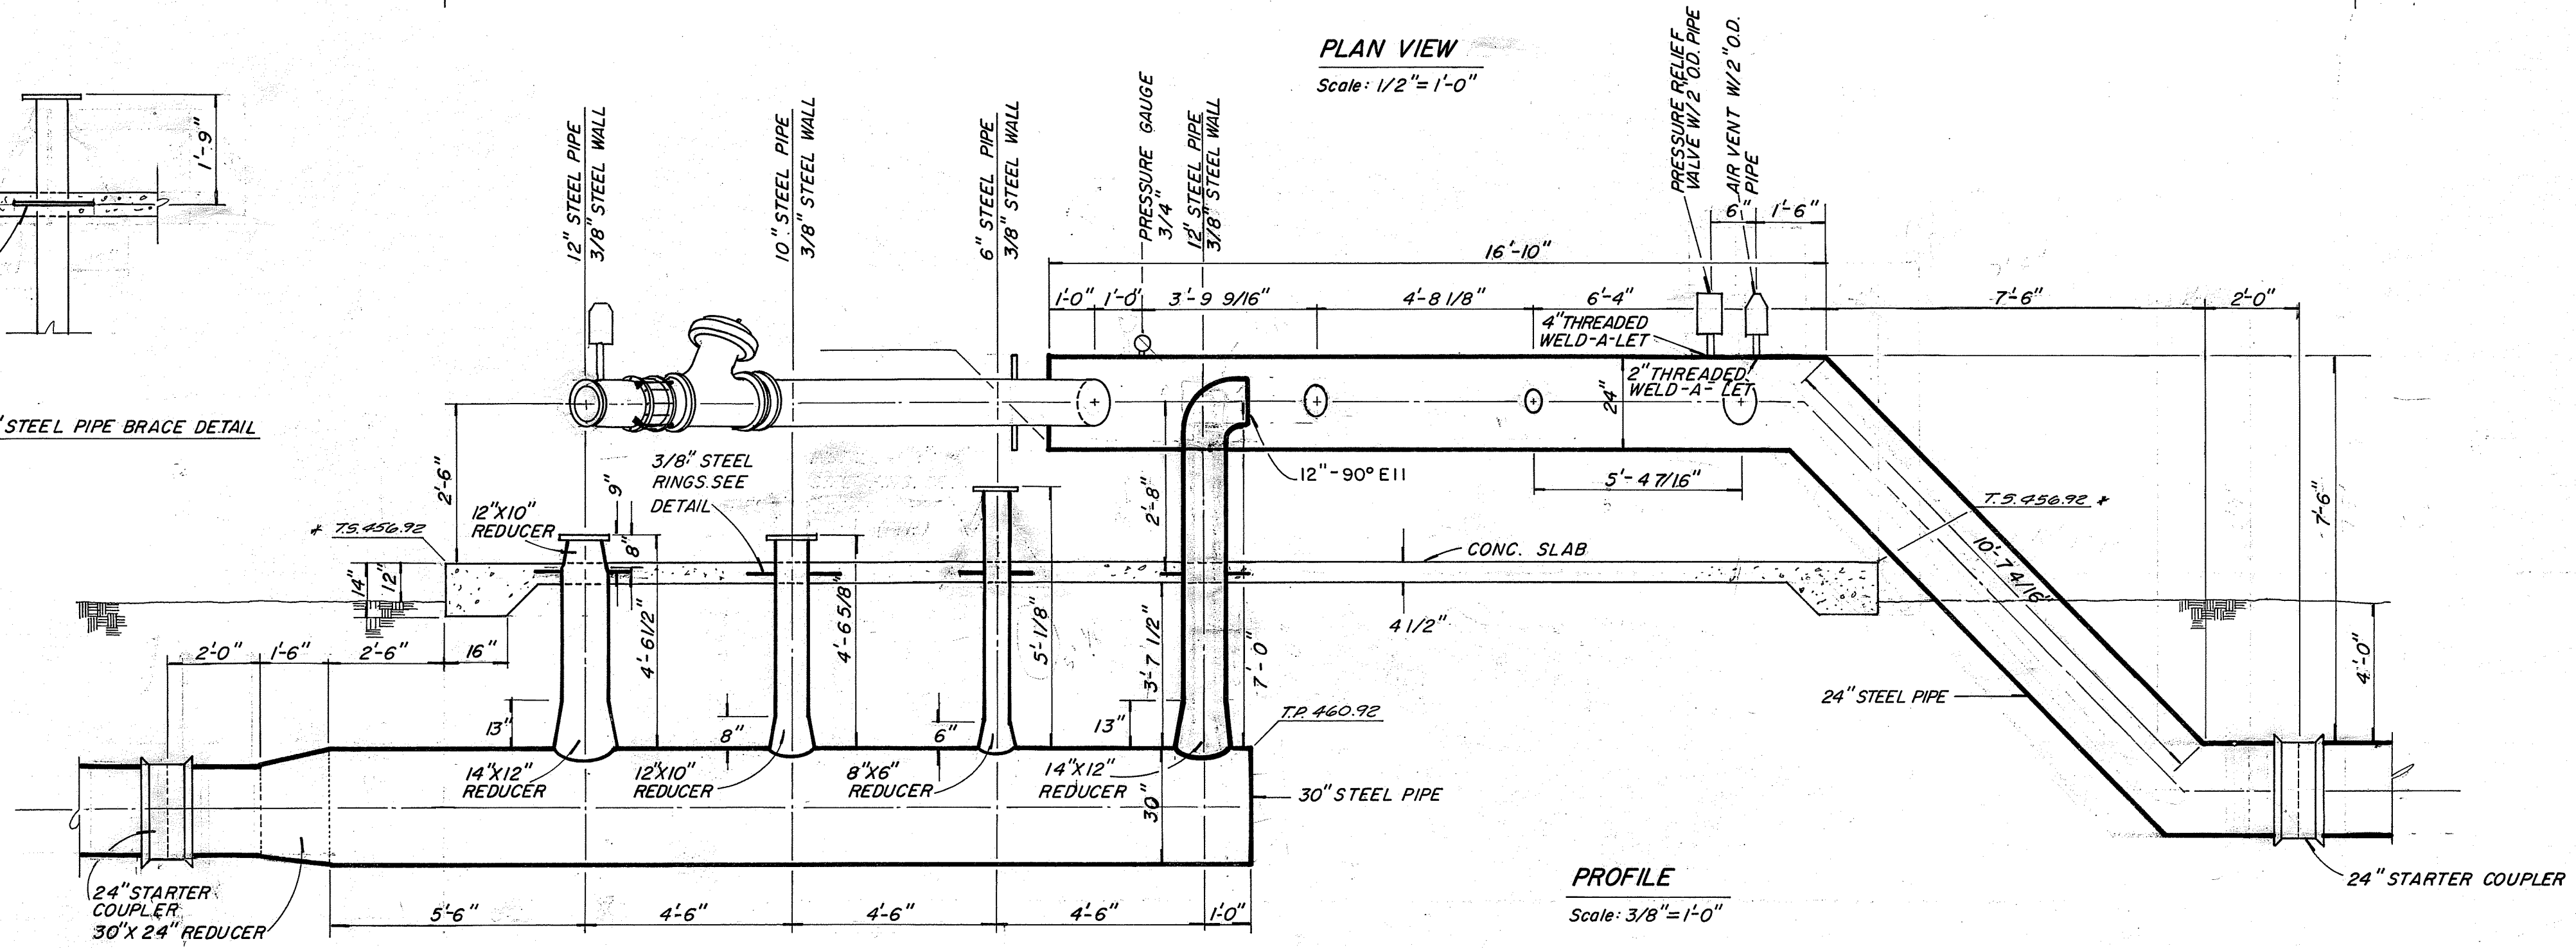

PROFILE
Scale: 3/8" = 1'-0"

BOOSTER PUMP STATION No. 8 SYSTEM No. 8			
ORANGE COVE IRRIGATION DISTRICT ORANGE COVE, CALIFORNIA			
Des.	SPG & B.G.	Date	2-95
Dwn.	R.G.M.	Recommended by	
Ckd		Approved by	
		Title	
		Sheet	Drawing No.
		No.	2
		of	2

